


**LEGEND OF ABBREVIATIONS & SYMBOLS**



EXISTING 2-FOOT CONTOUR	---98---
EXISTING 10-FOOT CONTOUR	---100---
EXISTING SPOT ELEVATION	x 77.53
RETAINING WALL	▬▬▬▬▬▬
WOOD STOCKADE FENCE	▬▬▬▬▬▬
METAL FENCE	▬▬▬▬▬▬
EDGE OF DISTURBED	~ ~ ~ ~ ~
SEWER MANHOLE	⊙
MANHOLE	⊙
WELL	⊙
WETLAND FLAG	WF
STONE (TYPICAL)	▬▬▬▬▬▬

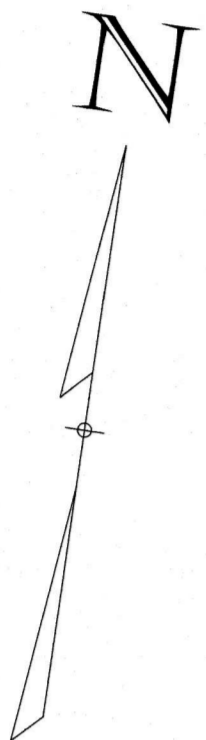

**AS-BUILT  
TWIN HILLS FARM  
IN  
ROWLEY, MA**

SCALE: 1" = 40' 0' 20' 40' 80' DATE: MARCH 9, 2023

**WILLIAMS & SPARGES**  
ENGINEERS | PLANNERS | SURVEYORS  
189 NORTH MAIN STREET  
SUITE 101  
MIDDLETON, MA 01949  
PHONE: (978) 539-8088  
FAX: (978) 539-8200  
WSENGINEERS.COM

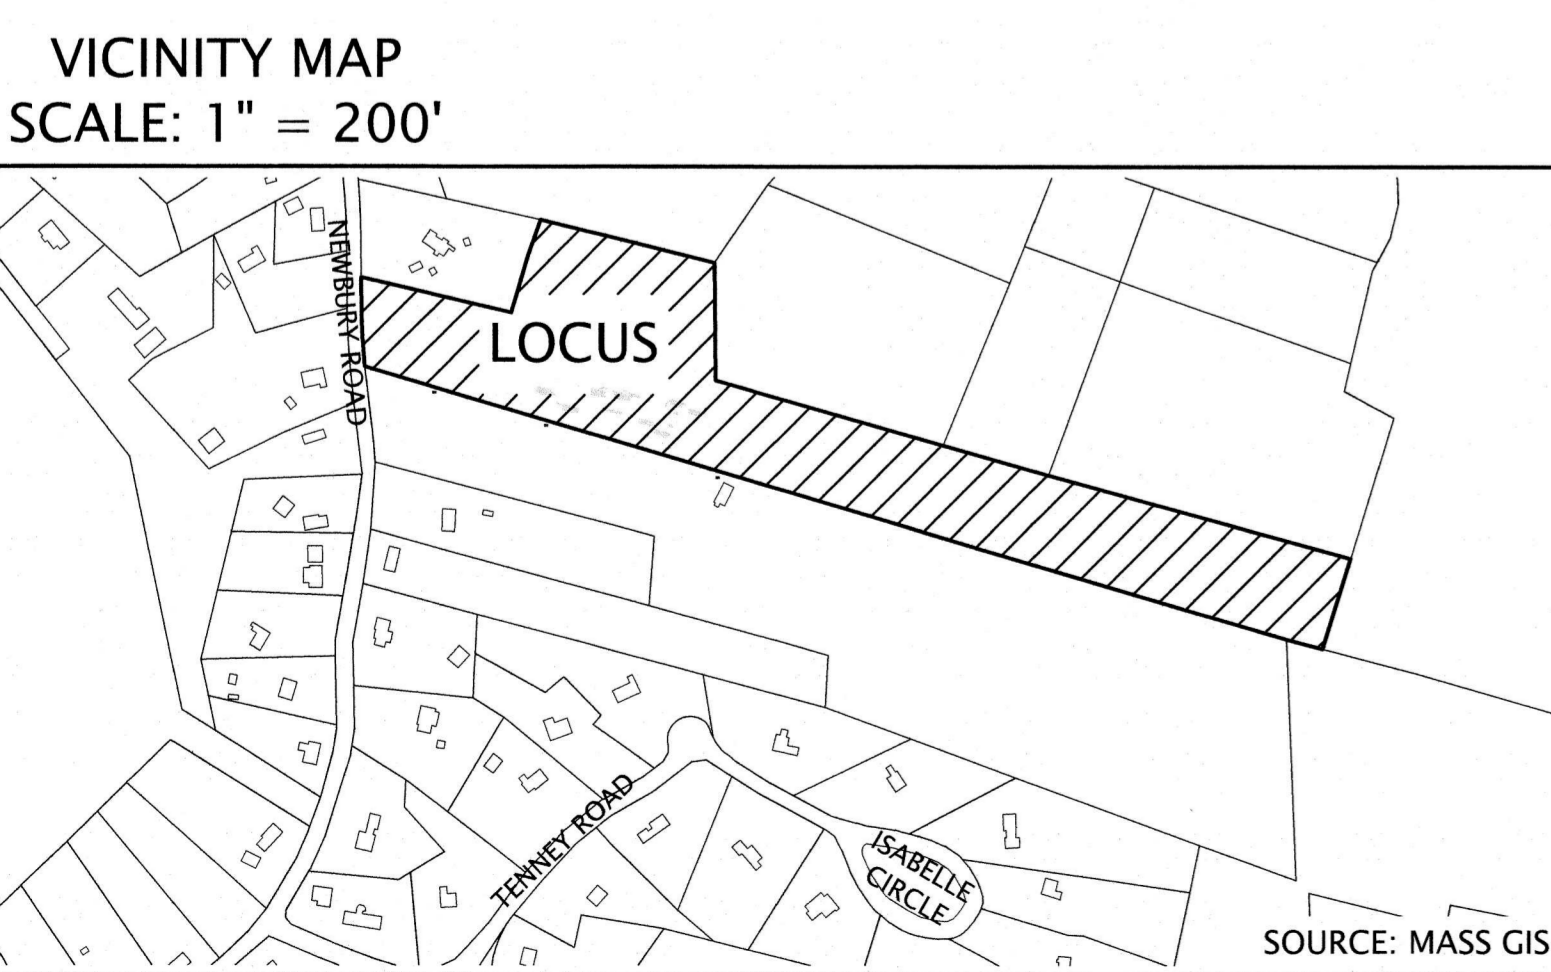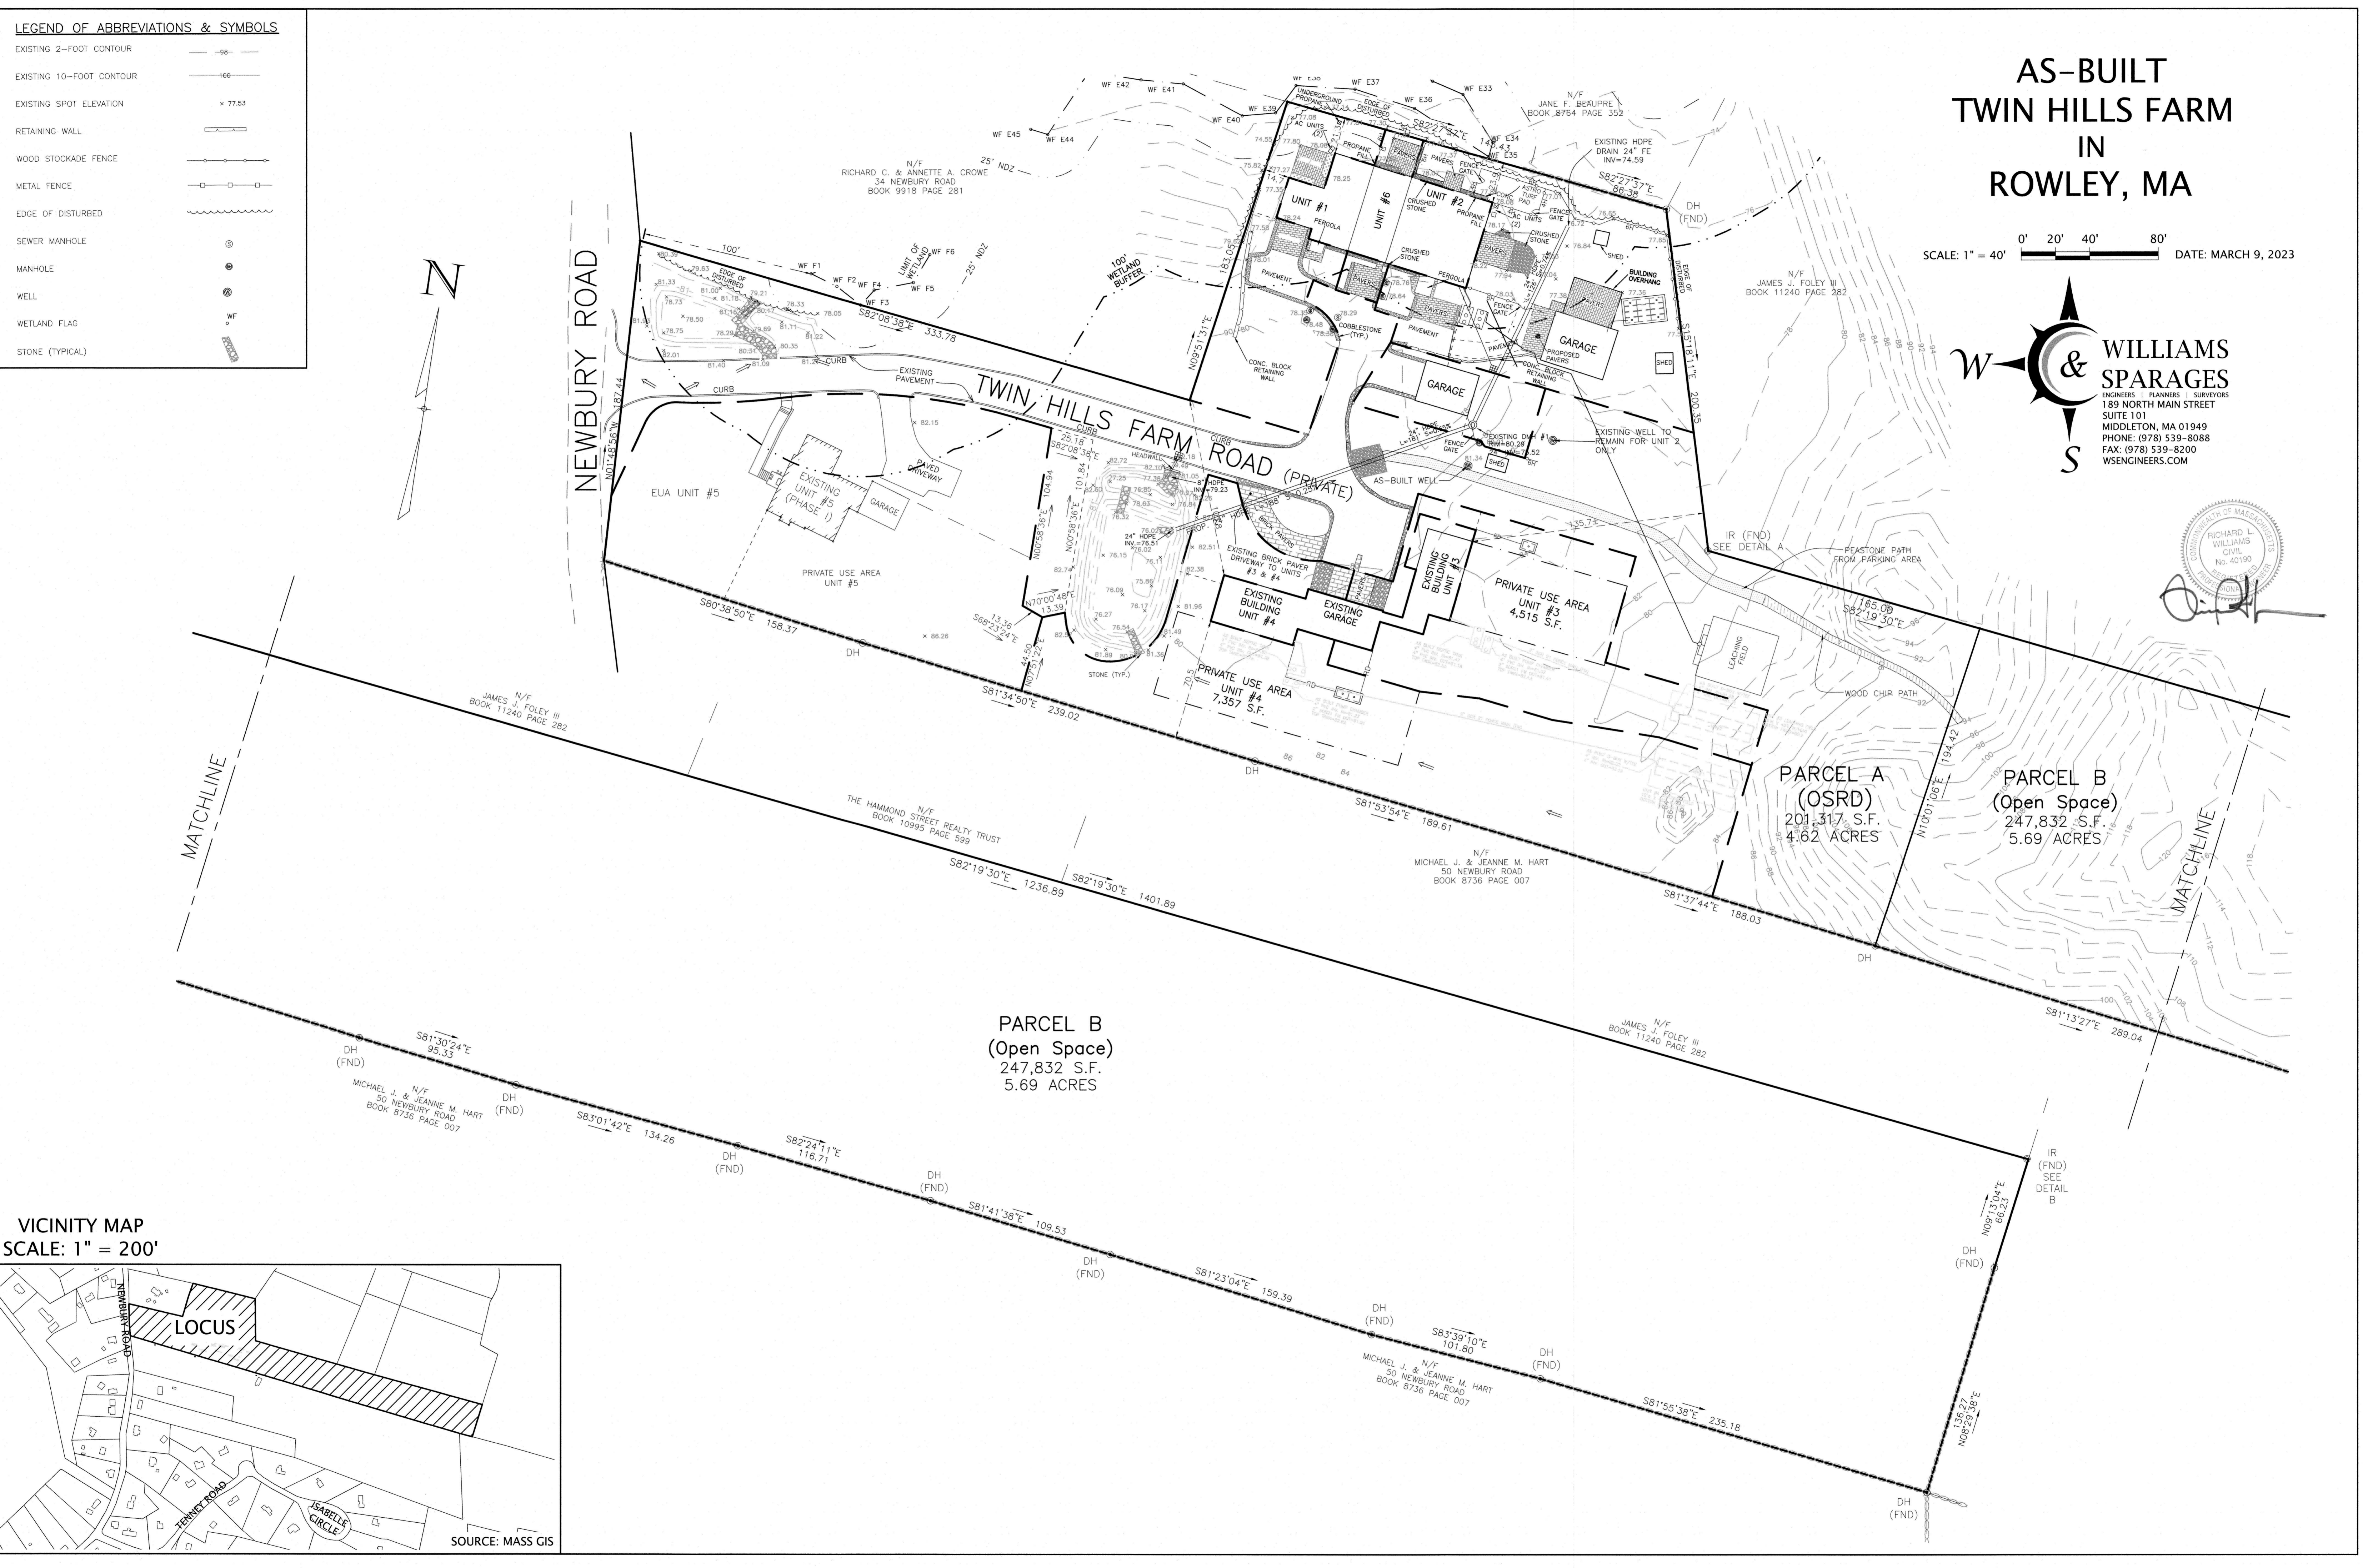

P:\DWG\_2019\42 Newbury Road\Drawings\AS-Built\AS-Built.dwg, 14