

ZONING DISTRICT: OUTLYING

ASSESSORS: MAP 12 BLOCK 3 LOT 2

REFERENCES:



DEED - BK. 40516 PG. 159

PLAN - PL. BK. 477 PL. 97

O.O.C. - BK. 39939 PG. 526

LEGEND & SYMBOLS

I.R.	IRON ROD
AC	AIR CONDITIONER
DMH	DRAIN MAN HOLE
CB	CATCH BASIN
P	PROPANE
.....	GARDEN/PLANTED AREA
~~~~~	BRUSH LINE

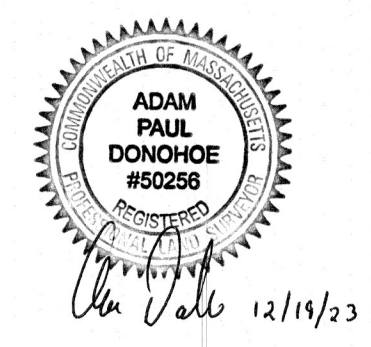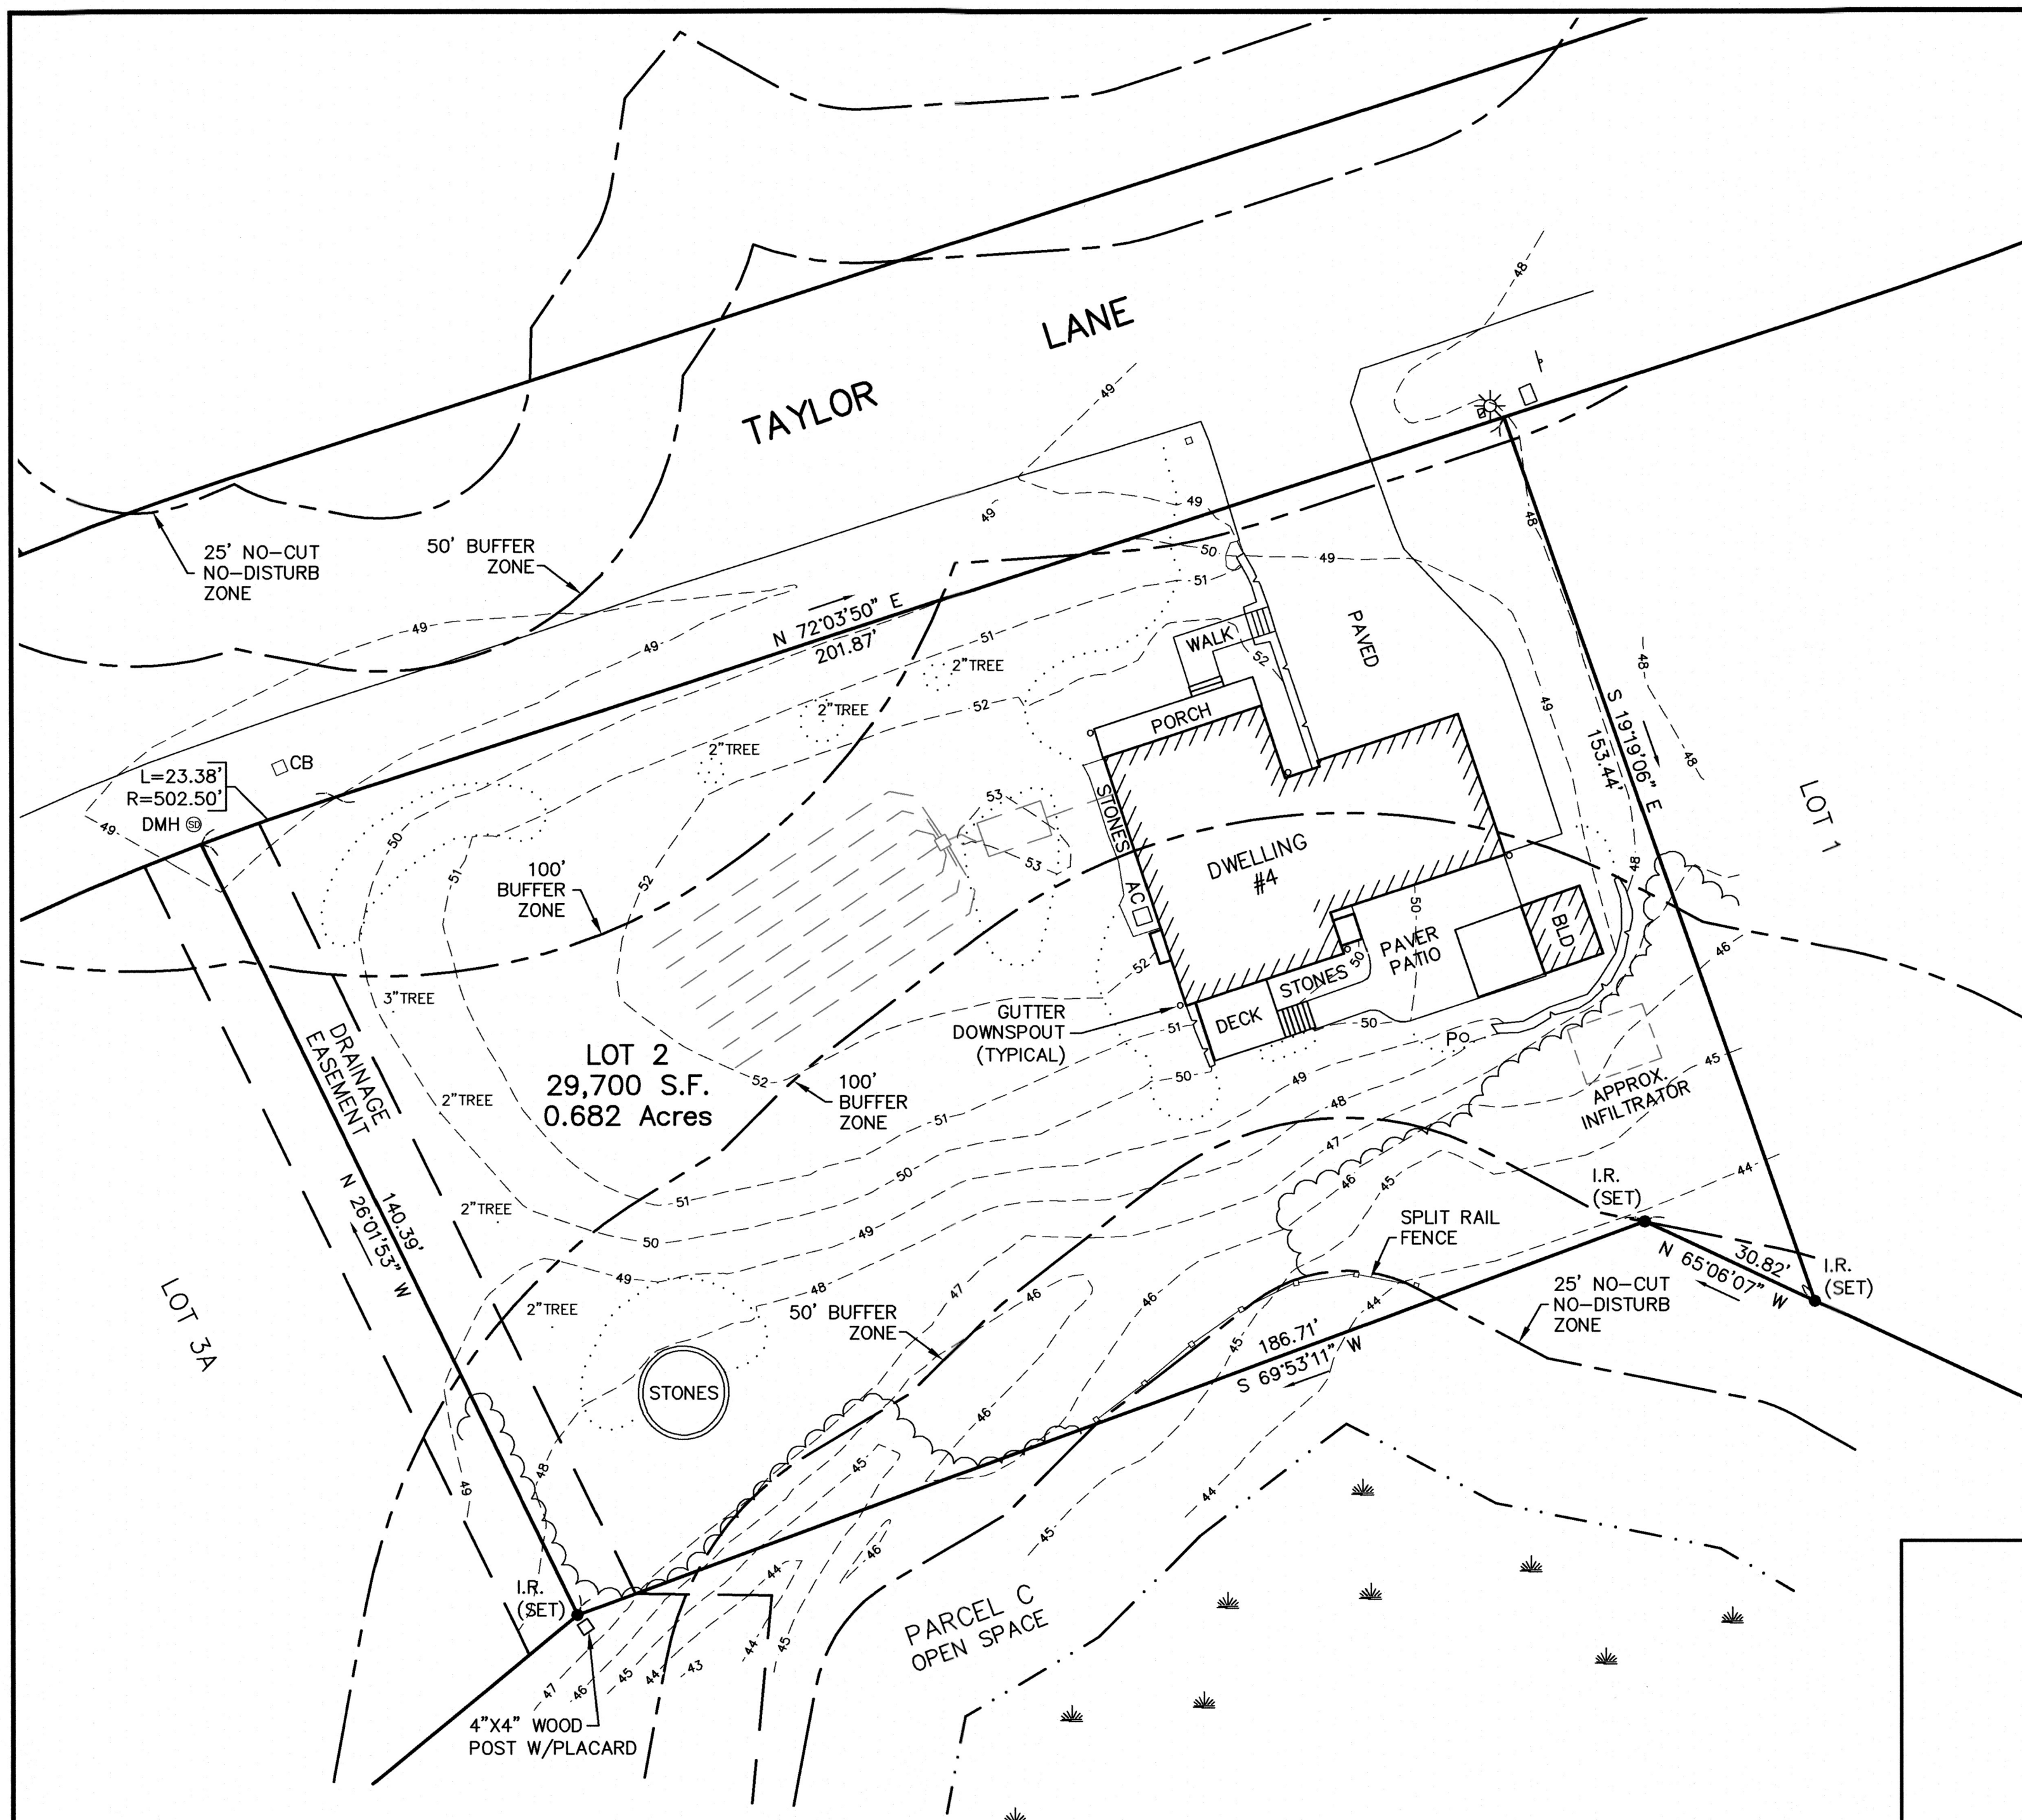

AS-BUILT SITE PLAN  
 #4 TAYLOR LANE  
**ROWLEY, MA**  
 PROPERTY OF  
**DANIEL & TERI LIN DISTASO**

SCALE: 1" = 20'      DECEMBER 19, 2023  
**DONOHOE SURVEY, INC.**  
 363 BOSTON ST.      TOPSFIELD, MA  
 (978) 887-6161

**NOTE:**  
 • INFILTRATOR SHOWN BASED ON INFORMATION PROVIDED BY THE BUILDER.

