

ZONING DISTRICT: OUTLYING

ASSESSORS: MAP 12 BLOCK 3 LOT 5

REFERENCES:




DEED - BK. 40777 PG. 481

PLAN - PL. BK. 477 PL. 97

O.O.C. - BK. 39939 PG. 484

LEGEND & SYMBOLS

- I.R. IRON ROD
- AC AIR CONDITIONER
- CB CATCH BASIN
- WG WATER GATE
- P PROPANE
- GEN. GENERATOR
- DMH DRAIN MAN HOLE
- GARDEN/PLANTED AREA
- ~~~~~ BRUSH LINE

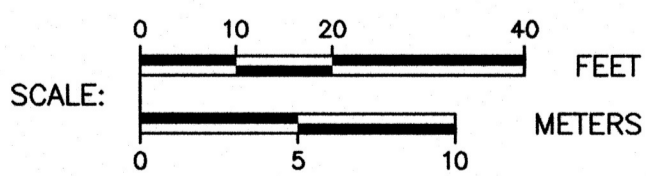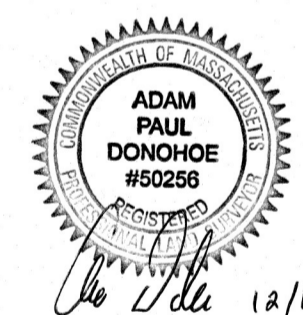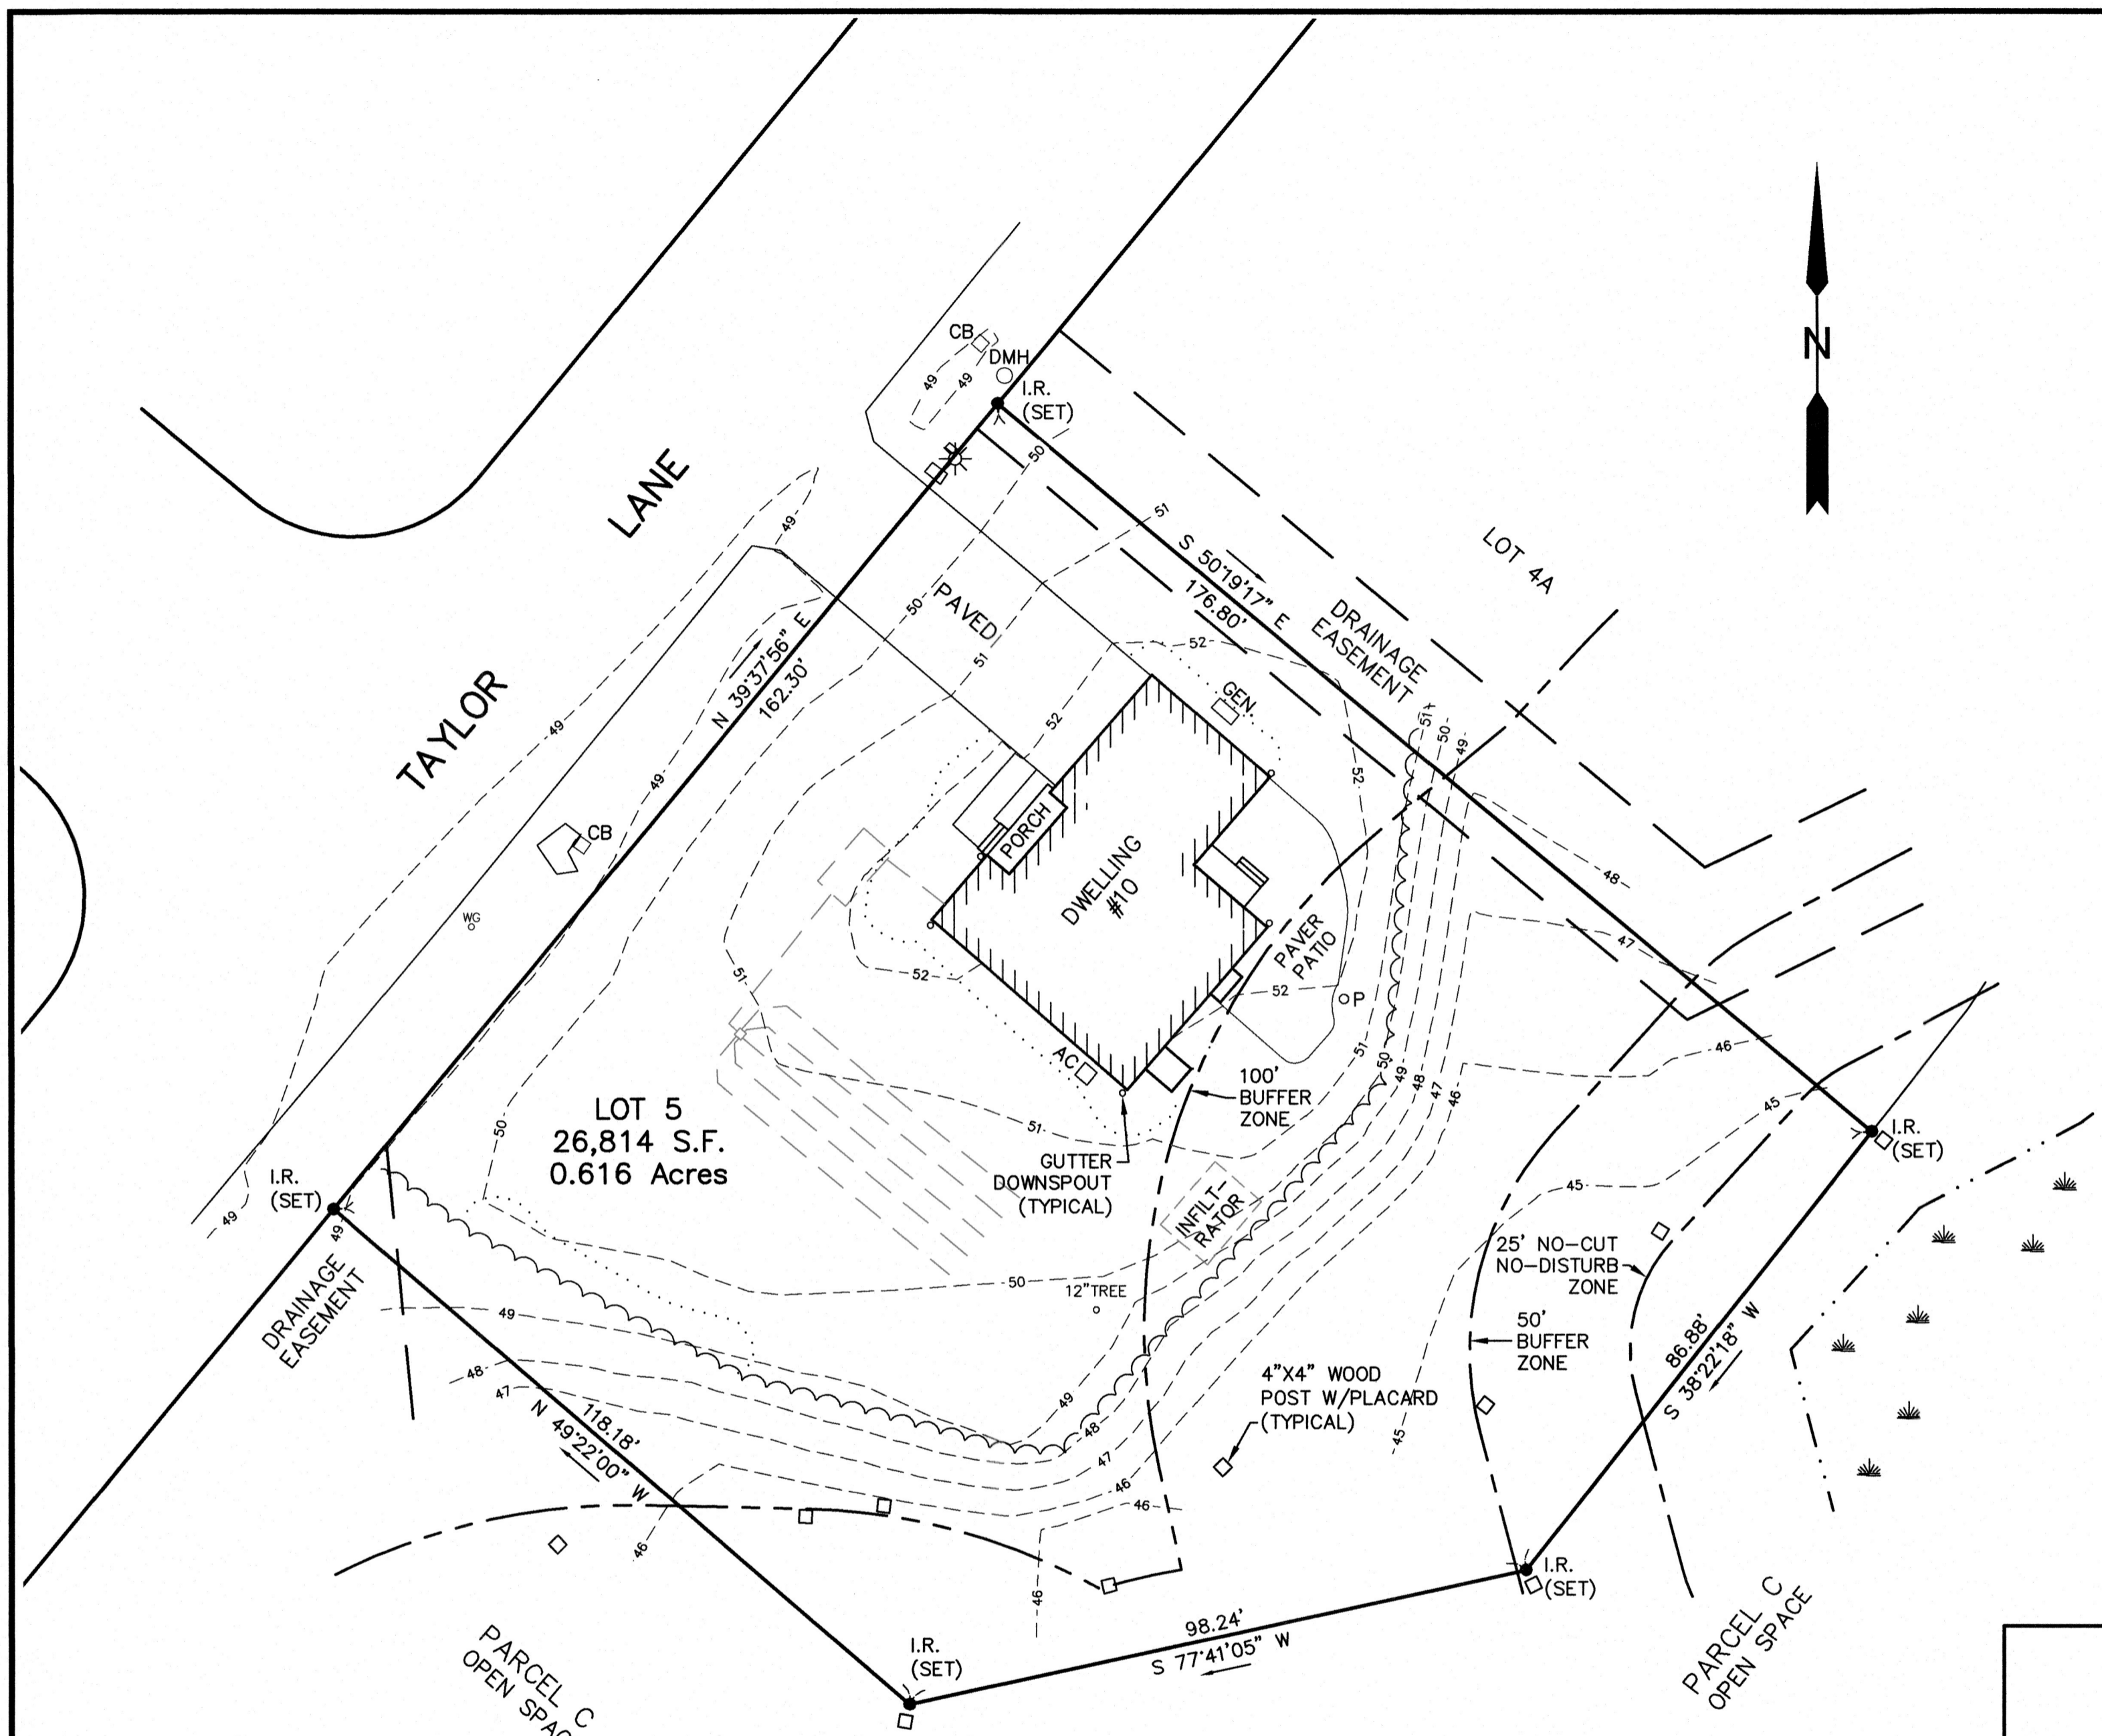

AS-BUILT SITE PLAN

#10 TAYLOR LANE

ROWLEY, MA

PROPERTY OF
SOCK LIVING TRUST

SCALE: 1" = 20' DECEMBER 11, 2023

DONOHOE SURVEY, INC.

363 BOSTON ST. TOPSFIELD, MA

(978) 887-6161

PROJ. 3569