

ZONING DISTRICT: OUTLYING

ASSESSORS: MAP 12 BLOCK 3 LOT 38

REFERENCES:


DEED - BK. 40566 PG. 299

PLAN - PL. BK. 477 PL. 97

O.O.C. - BK. 39939 PG. 505

### LEGEND & SYMBOLS

I.R.	IRON ROD
AC	AIR CONDITIONER
T	TREE
CB	CATCH BASIN
WG	WATER GATE
P	PROPANE
.....	GARDEN/PLANTED AREA
~~~~~	TREE LINE

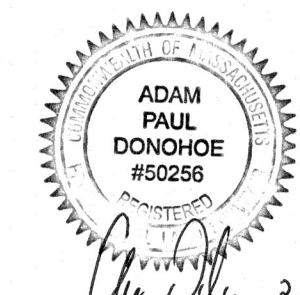

## AS-BUILT SITE PLAN

#5 TAYLOR LANE

# ROWLEY, MA

PROPERTY OF

THOMAS CHASE & PATRICA V. PINO-CHASE


SCALE: 1" = 20'      FEBRUARY 7, 2024

**DONOHUE SURVEY, INC.**

363 BOSTON ST.      TOPSFIELD, MA

(978) 887-6161

PROJ. 3569

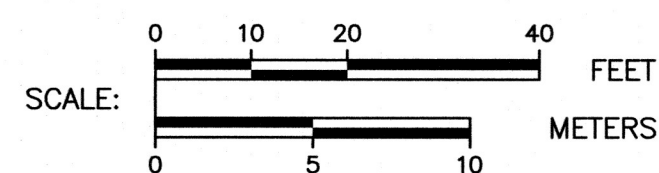

**NOTE:**

• INFILTRATOR SHOWN BASED ON INFORMATION PROVIDED BY THE BUILDER.

