AS-BUILT
TWIN HILLS FARM
IN
ROWLEY, MA

SCALE: 1" = 40' | 0' 20' 40' 80' | DATE: JUNE 26, 2023

WILLIAMS & SPARAGES
ENGINEERS | SCIENTISTS | SURVEYORS
189 NORTH MAIN STREET
SUITE 101
MIDDLETON, MA 01949
PHONE: (978) 539-8088
FAX: (978) 539-8200
WSENGINEERS.COM

RICHARD L. WILLIAMS
CIVIL
No. 40190
REGISTERED PROFESSIONAL ENGINEER
COMMONWEALTH OF MASSACHUSETTS

LEGEND OF ABBREVIATIONS & SYMBOLS

- EXISTING 2-FOOT CONTOUR
- EXISTING 10-FOOT CONTOUR
- EXISTING SPOT ELEVATION
- RETAINING WALL
- WOOD STOCKADE FENCE
- METAL FENCE
- EDGE OF DISTURBED
- SEWER MANHOLE
- MANHOLE
- WELL
- WETLAND FLAG
- STONE (TYPICAL)

N

NEWBURY ROAD

TWIN HILLS FARM ROAD (PRIVATE)

N/F
RICHARD C. & ANNETTE A. CROWE
34 NEWBURY ROAD
BOOK 9918 PAGE 281

N/F
JANE F. BEAUPRE
BOOK 8764 PAGE 352

N/F
JAMES J. FOLEY III
BOOK 11240 PAGE 282

N/F
THE HAMMOND STREET REALTY TRUST
BOOK 10995 PAGE 599

N/F
MICHAEL J. & JEANNE M. HART
50 NEWBURY ROAD
BOOK 8736 PAGE 007

EUA UNIT #5

EXISTING UNIT #5 (PHASE I)

PRIVATE USE AREA UNIT #5

PRIVATE USE AREA UNIT #4 7,357 S.F.

PRIVATE USE AREA UNIT #3 4,515 S.F.

EXISTING BUILDING UNIT #4

EXISTING GARAGE

EXISTING BUILDING UNIT #3

UNIT #1

UNIT #2

UNIT #6

GARAGE

PROPOSED GARAGE

AS-BUILT WELL

EXISTING WELL

EXISTING HDPE DRAIN 24" FE INV=74.59

EXISTING BRICK PAVER DRIVEWAY TO UNITS #3 & #4

EXISTING PAVED DRIVEWAY

ROOF RECHARGE SYSTEM

INSPECTION PORT (TYP.)

LEACHING FIELD

PEASTONE PATH FROM PARKING AREA

WOOD CHIP PATH

PARCEL A
(OSRD)
201,317 S.F.
4.62 ACRES

PARCEL B
(Open Space)
247,832 S.F.
5.69 ACRES

PARCEL B
(Open Space)
247,832 S.F.
5.69 ACRES

MATCHLINE

MATCHLINE

S82°08'38"E 333.78

S80°38'50"E 158.37

S81°34'50"E 239.02

S81°53'54"E 189.61

S82°19'30"E 1236.89

S82°19'30"E 1401.89

S81°37'44"E 188.03

S81°13'27"E 289.04

S81°30'24"E 95.33

S83°01'42"E 134.26

S82°24'11"E 116.71

S81°41'36"E 109.53

S81°23'04"E 159.39

S83°39'10"E 101.80

S81°55'38"E 235.18

N07°48'56"W 1187.44

N10°58'36"E 104.94

N70°00'48"E 13.38

S68°23'24"E 13.36

N09°51'13"E 83.05

S82°27'37"E 66.38

S15°18'11"E 200.35

N10°01'06"E 194.42

N09°13'04"E 68.23

N08°29'59"E 136.27

DH (FND)

IR (FND) SEE DETAIL B

GRANITE MEASUREMENT POST

WOOD POST CONSERVATION MARKER (TYP.)

WOOD POST

24" HDPE INV=76.51

8" HDPE INV=79.23

STONE (TYP.)

COBBLESTONE (TYP.)

CONC. BLOCK RETAINING WALL

EDGE OF DISTURBED

LIMIT OF WETLAND

100' WETLAND BUFFER

25' NDZ

CURB

EXISTING PAVEMENT

VICINITY MAP
SCALE: 1" = 200'

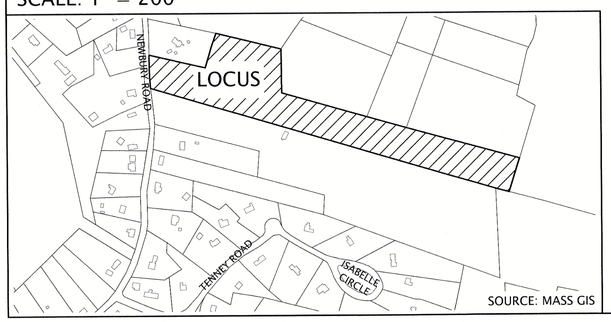

NOTES:
1. AS-BUILT INFORMATION IS A COMBINATION OR AN ACTUAL INSTRUMENT SURVEY BY WILLIAMS & SPARAGES AND INFORMATION PROVIDED BY THE DEVELOPER.

P:\NEWL 0019\42 Newbury Road\Drawings\ABCNOVphaseIV_R1.dwg, TR